
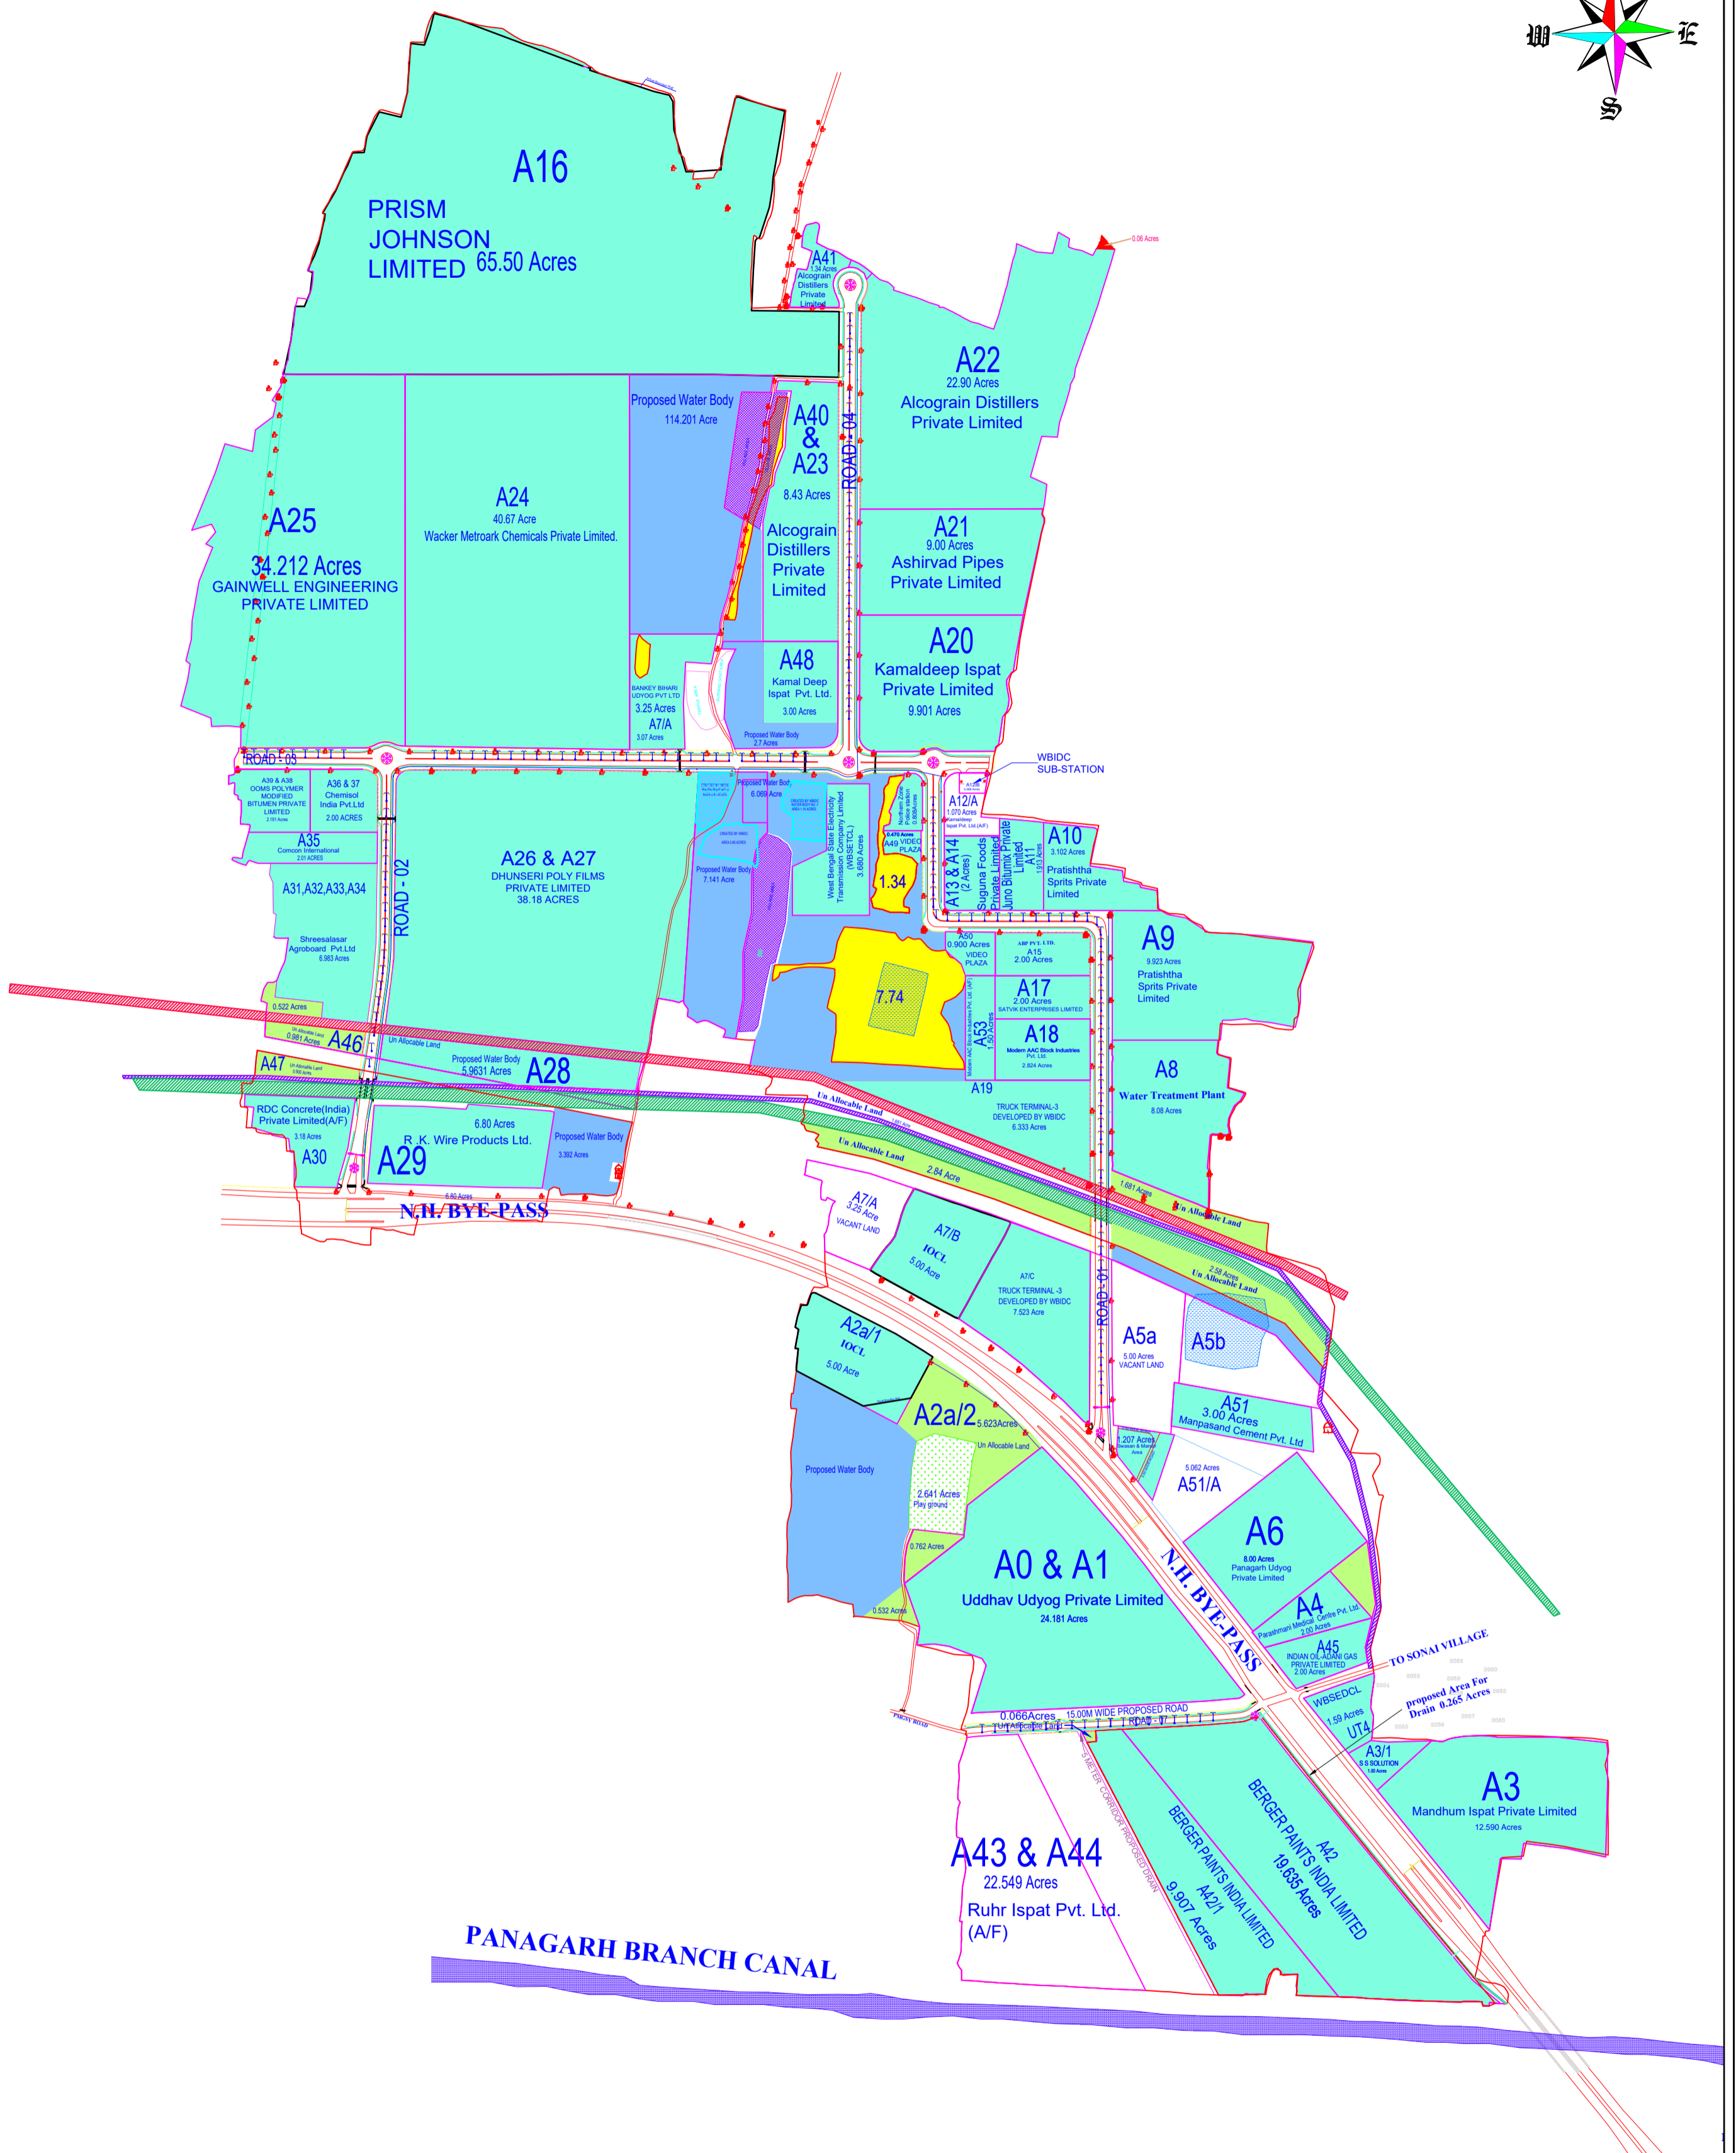


MASTER PLAN OF NORTHERN SIDE PANAGARH INDUSTRIAL PARK, PASHIM BARDHAMAN, WEST BENGAL

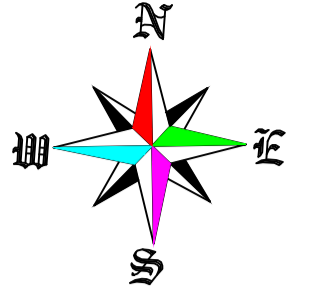

LEGEND	
RIVER	[Symbol]
BOUNDARY WALL	[Symbol]
BRIDGE	[Symbol]
CABAL CHAMBER	[Symbol]
CALVART	[Symbol]
DRAIN	[Symbol]
ELECTRIC POST	[Symbol]
ENCLOSMENT	[Symbol]
FEEDER BOX	[Symbol]
FLY OVER	[Symbol]
GATE	[Symbol]
HIGH MUST	[Symbol]
ICDS SCHOOL	[Symbol]
PLAY GROUND	[Symbol]
ROAD	
SASAN MONDIR AREA	[Symbol]
SDB BOX	[Symbol]
SLDB BOX	[Symbol]
STREET LIGHT	[Symbol]
SWITCH VALVE	[Symbol]
TEMPLE	[Symbol]
TRANSFORMER	[Symbol]
Rail Track	[Symbol]
Building	[Symbol]
P.I.P.B.M	[Symbol]
H.T TOWER	[Symbol]
IOC PIPE LINE	[Symbol]
ESSAR PIPE LINE	[Symbol]
UTILITY POWER CORRIDOR	[Symbol]

LIST OF REFERENCE MASTER PILLAR			
SL. NO.	NORTHING	EASTING	POINT ID
1	2594564.2960	547755.873	PIP-1
2	2594498.884	547880.418	PIP-2
3	2592025.264	550225.563	PIP-3
4	2591998.799	550364.777	PIP-4
5	2595106.857	547612.132	PIP-5
6	2595107.541	547644.785	PIP-6
7	2591711.075	550996.303	PIP-7
8	2591708.111	551020.854	PIP-8

NOTES:-
 1. All Dimensions Are In m. Unless Otherwise Noted.
 2. All Coordinate Are In True Coordinate

CLIENT	West Bengal Industrial Development Corporation		
TITLE :	As Built MASTER PLAN AND TOPOGRAPHICAL SURVEY DRAWING OF NORTHERN SIDE PANAGARH INDUSTRIAL PARK		
Drawing No.:-	DWG NO. PAN/FTS - 001		
Work Order No.:-			
CONSULTANT:			
	NAME	DATE	
DRAWN+SURVEY	D.N	02.12.25	SHEET: 0
DESIGNED			SCALE:
CHECKED			
APPROVED			
Survey Agency		Rev.	0
SURVEYOR:	S S Solution		
	AS-4/11, Srinagar Pally, Benachity, Durgapur-13		
	MOBILE:- 9434388866		
	Website:- www.sssolutiongroup.com		
	EMAIL ID:- sssolution_88@rediffmail.		