
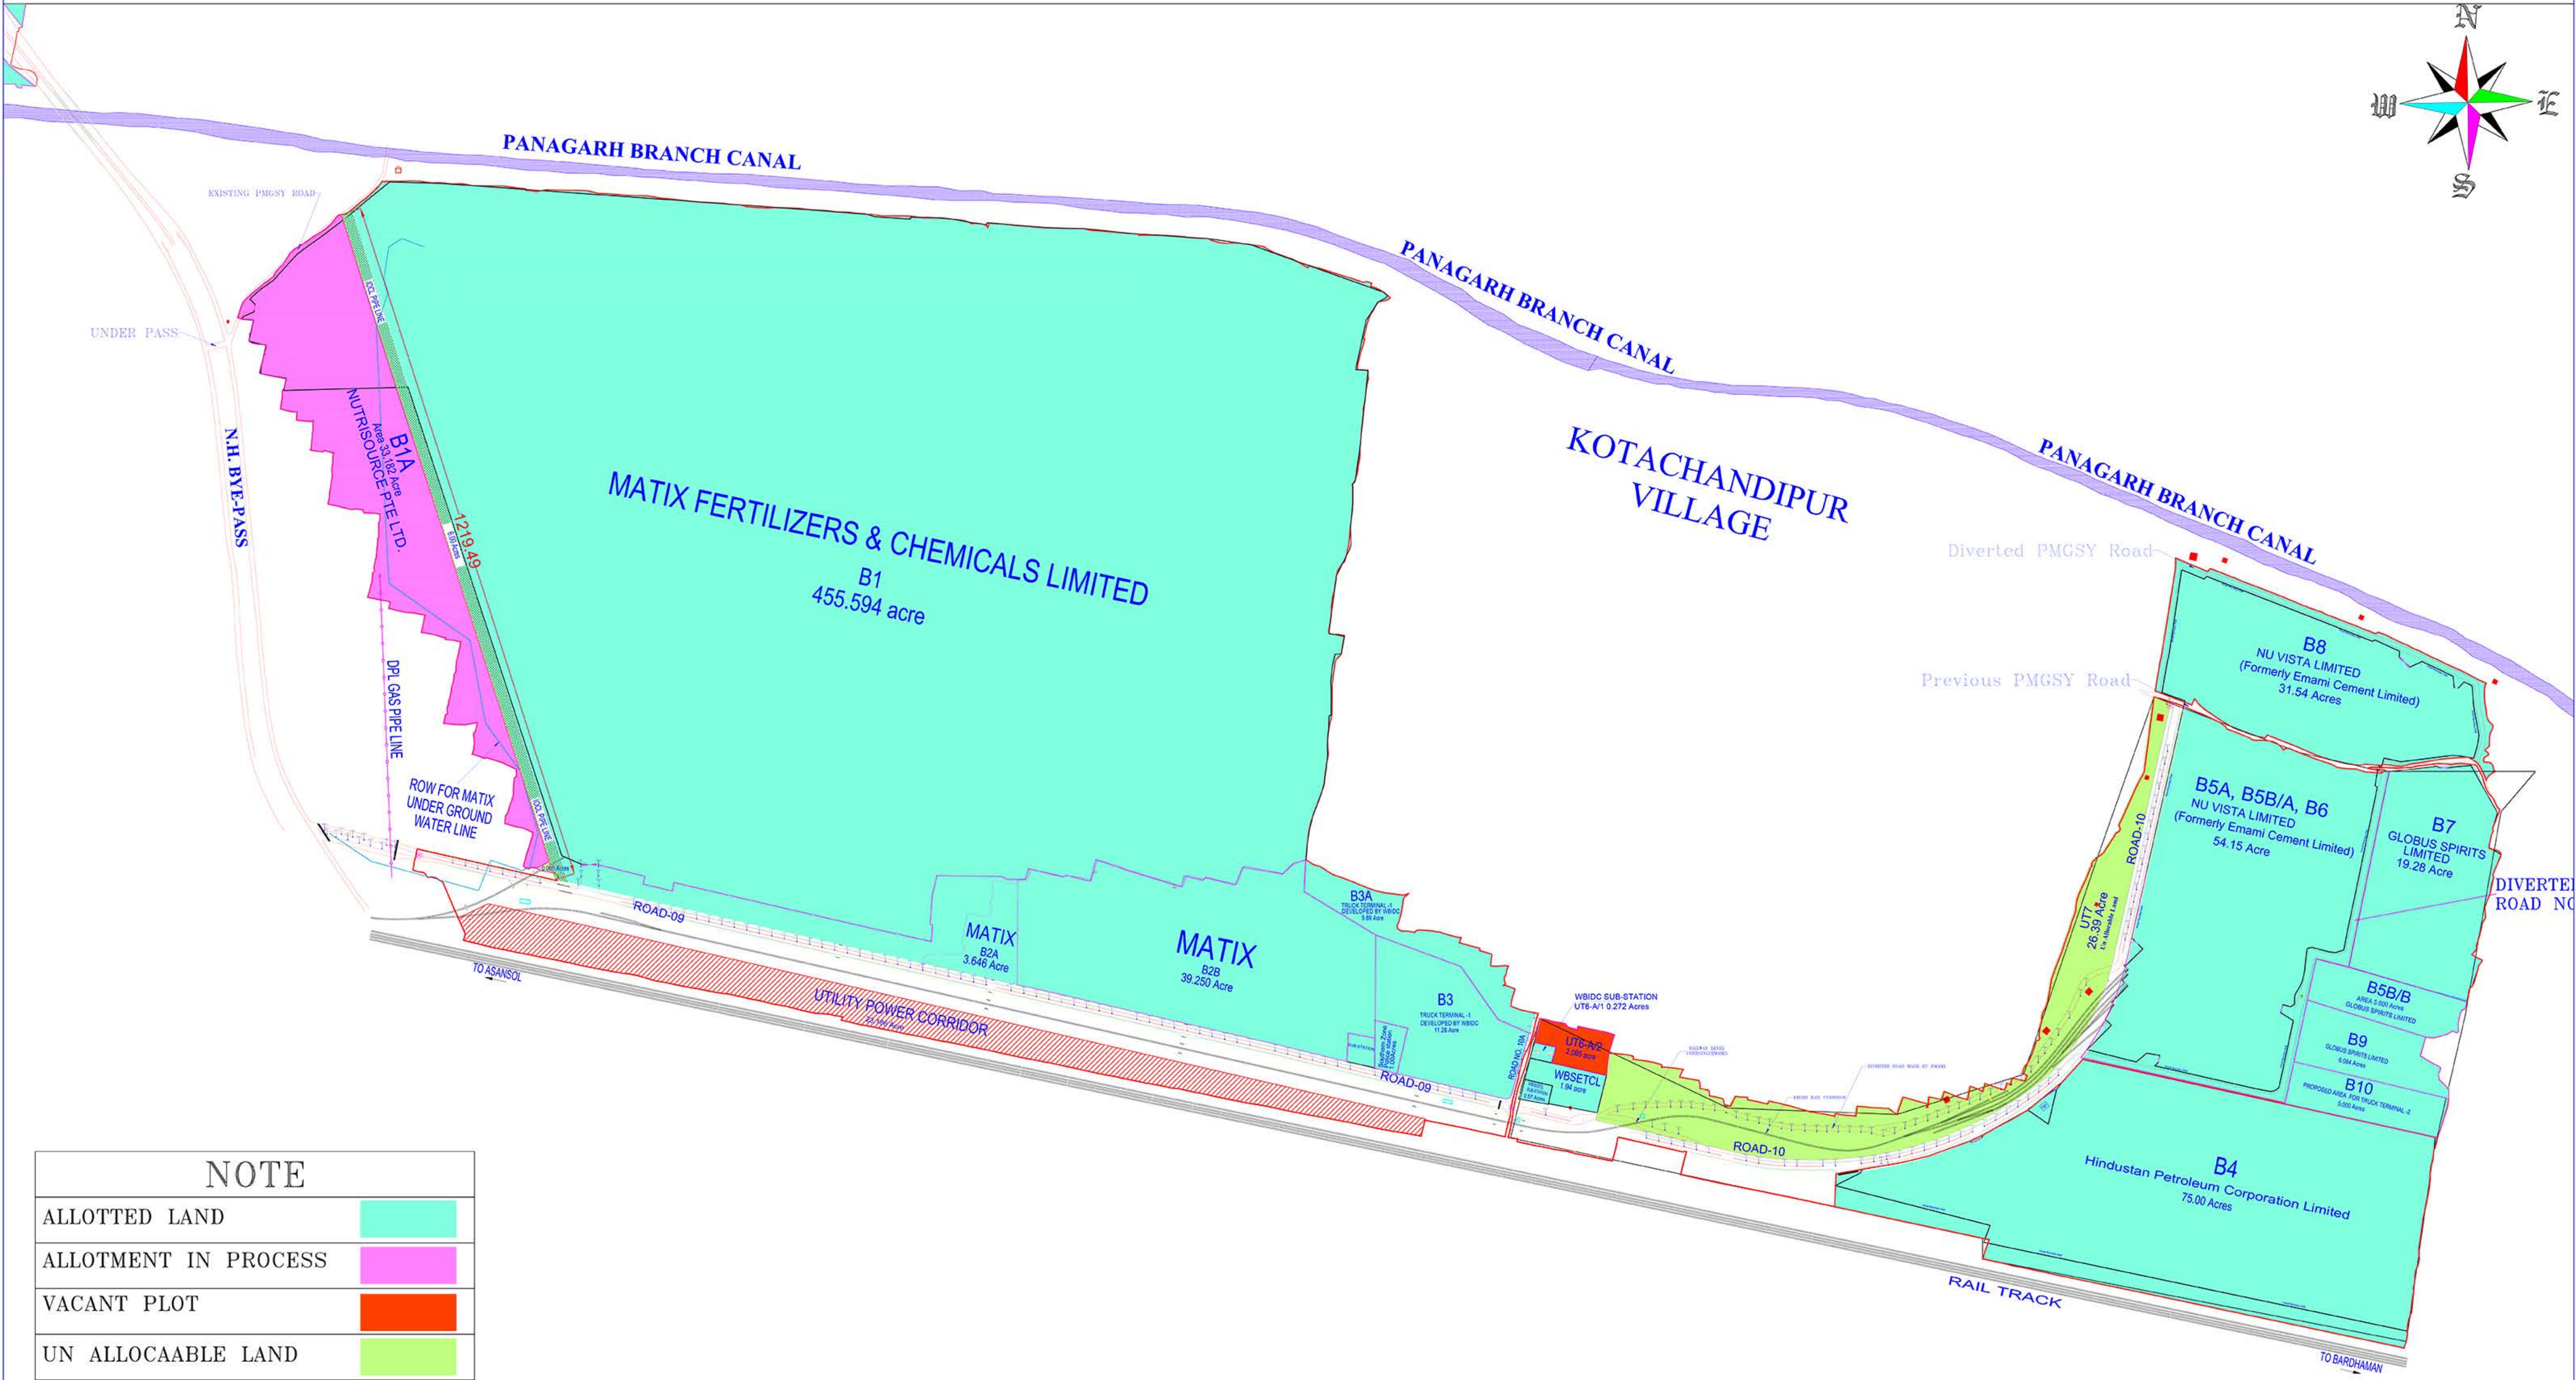


MASTER PLAN OF SOUTH THEN SIDE PANAGARH INDUSTRIAL PARK, PASHIM BARDHAMAN, WEST BENGAL

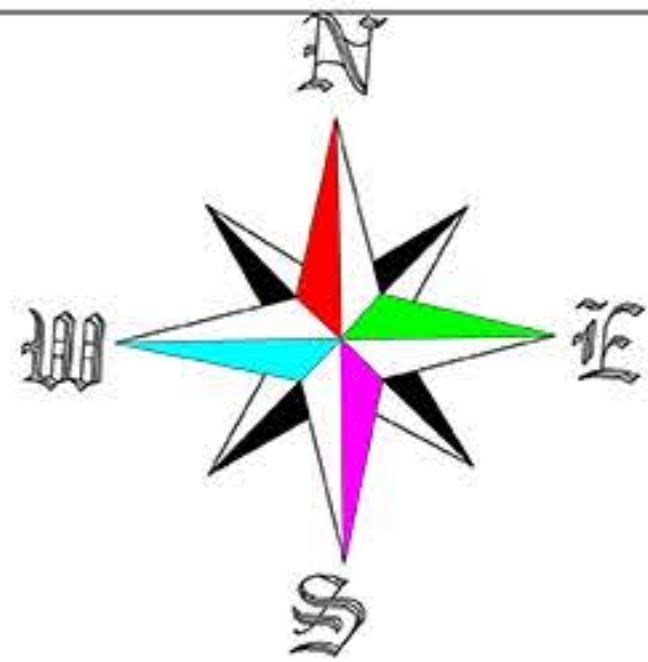

NOTE	
ALLOTTED LAND	
ALLOTMENT IN PROCESS	
VACANT PLOT	
UN ALLOCAABLE LAND	

LIST OF REFERENCE MASTER PILLAR			
SL. NO.	NORTHING	EASTING	POINT ID
1	2594564.2960	547755.873	PIP-1
2	2594498.884	547880.418	PIP-2
3	2592025.264	550225.563	PIP-3
4	2591998.799	550364.777	PIP-4
5	2595108.857	547612.132	PIP-5
6	2595107.541	547644.785	PIP-6
7	2591711.075	550996.303	PIP-7
8	2591708.111	551020.854	PIP-8

LEGEND	
RIVER	
BOUNDARY WALL	
CASAL CHAMBER	
CALVART	
ELECTRIC POST	
ENCLOSMENT	
FEEDER BOX	
FLY OVER	
GATE	
HIGH MUST	
ICDS SCHOOL	
PLAY GROUND	
ROAD	
SASAN MONDIR AREA	
SDB BOX	
SLDB BOX	
STREET LIGHT	
SWITCH VALVE	
TAMPLE	
TRANSPORMIA	
Rail Track	
P.I.P. & M	
H.T TOWER	
IOC PIPE LINE	
ESSAR PIPE LINE	
UTILITY POWER CORRIDOR	

NOTES:-
1. All Dimensions Are In m. Unless Otherwise Noted.
2. All Coordinate Are In True Coordinate

CLIENT	West Bengal Industrial Development Corporation
TITLE	AS BUILT MASTER PLAN AND TOPOGRAPHICAL SURVEY DRAWING OF NORTHERN SIDE PANAGARH INDUSTRIAL PARK
Drawing No.:-	
Work Order No.:-	
CONSULTANT:	
NAME	DATE
DRAWN-SURVEY	N.C.K. 28.01.2023
DESIGNED	
CHECKED	
APPROVED	
Survey Agency	Rev.
SURVEYOR	
MOBILE:- 9434388888	
AS-4/11, Srinagar Pally, Benachity, Durgapur-13	
MOBILE:- 9434388888	
Website:- www.sssolutiongroup.com	
EMAIL ID:- sssolution_group@gmail.com	