


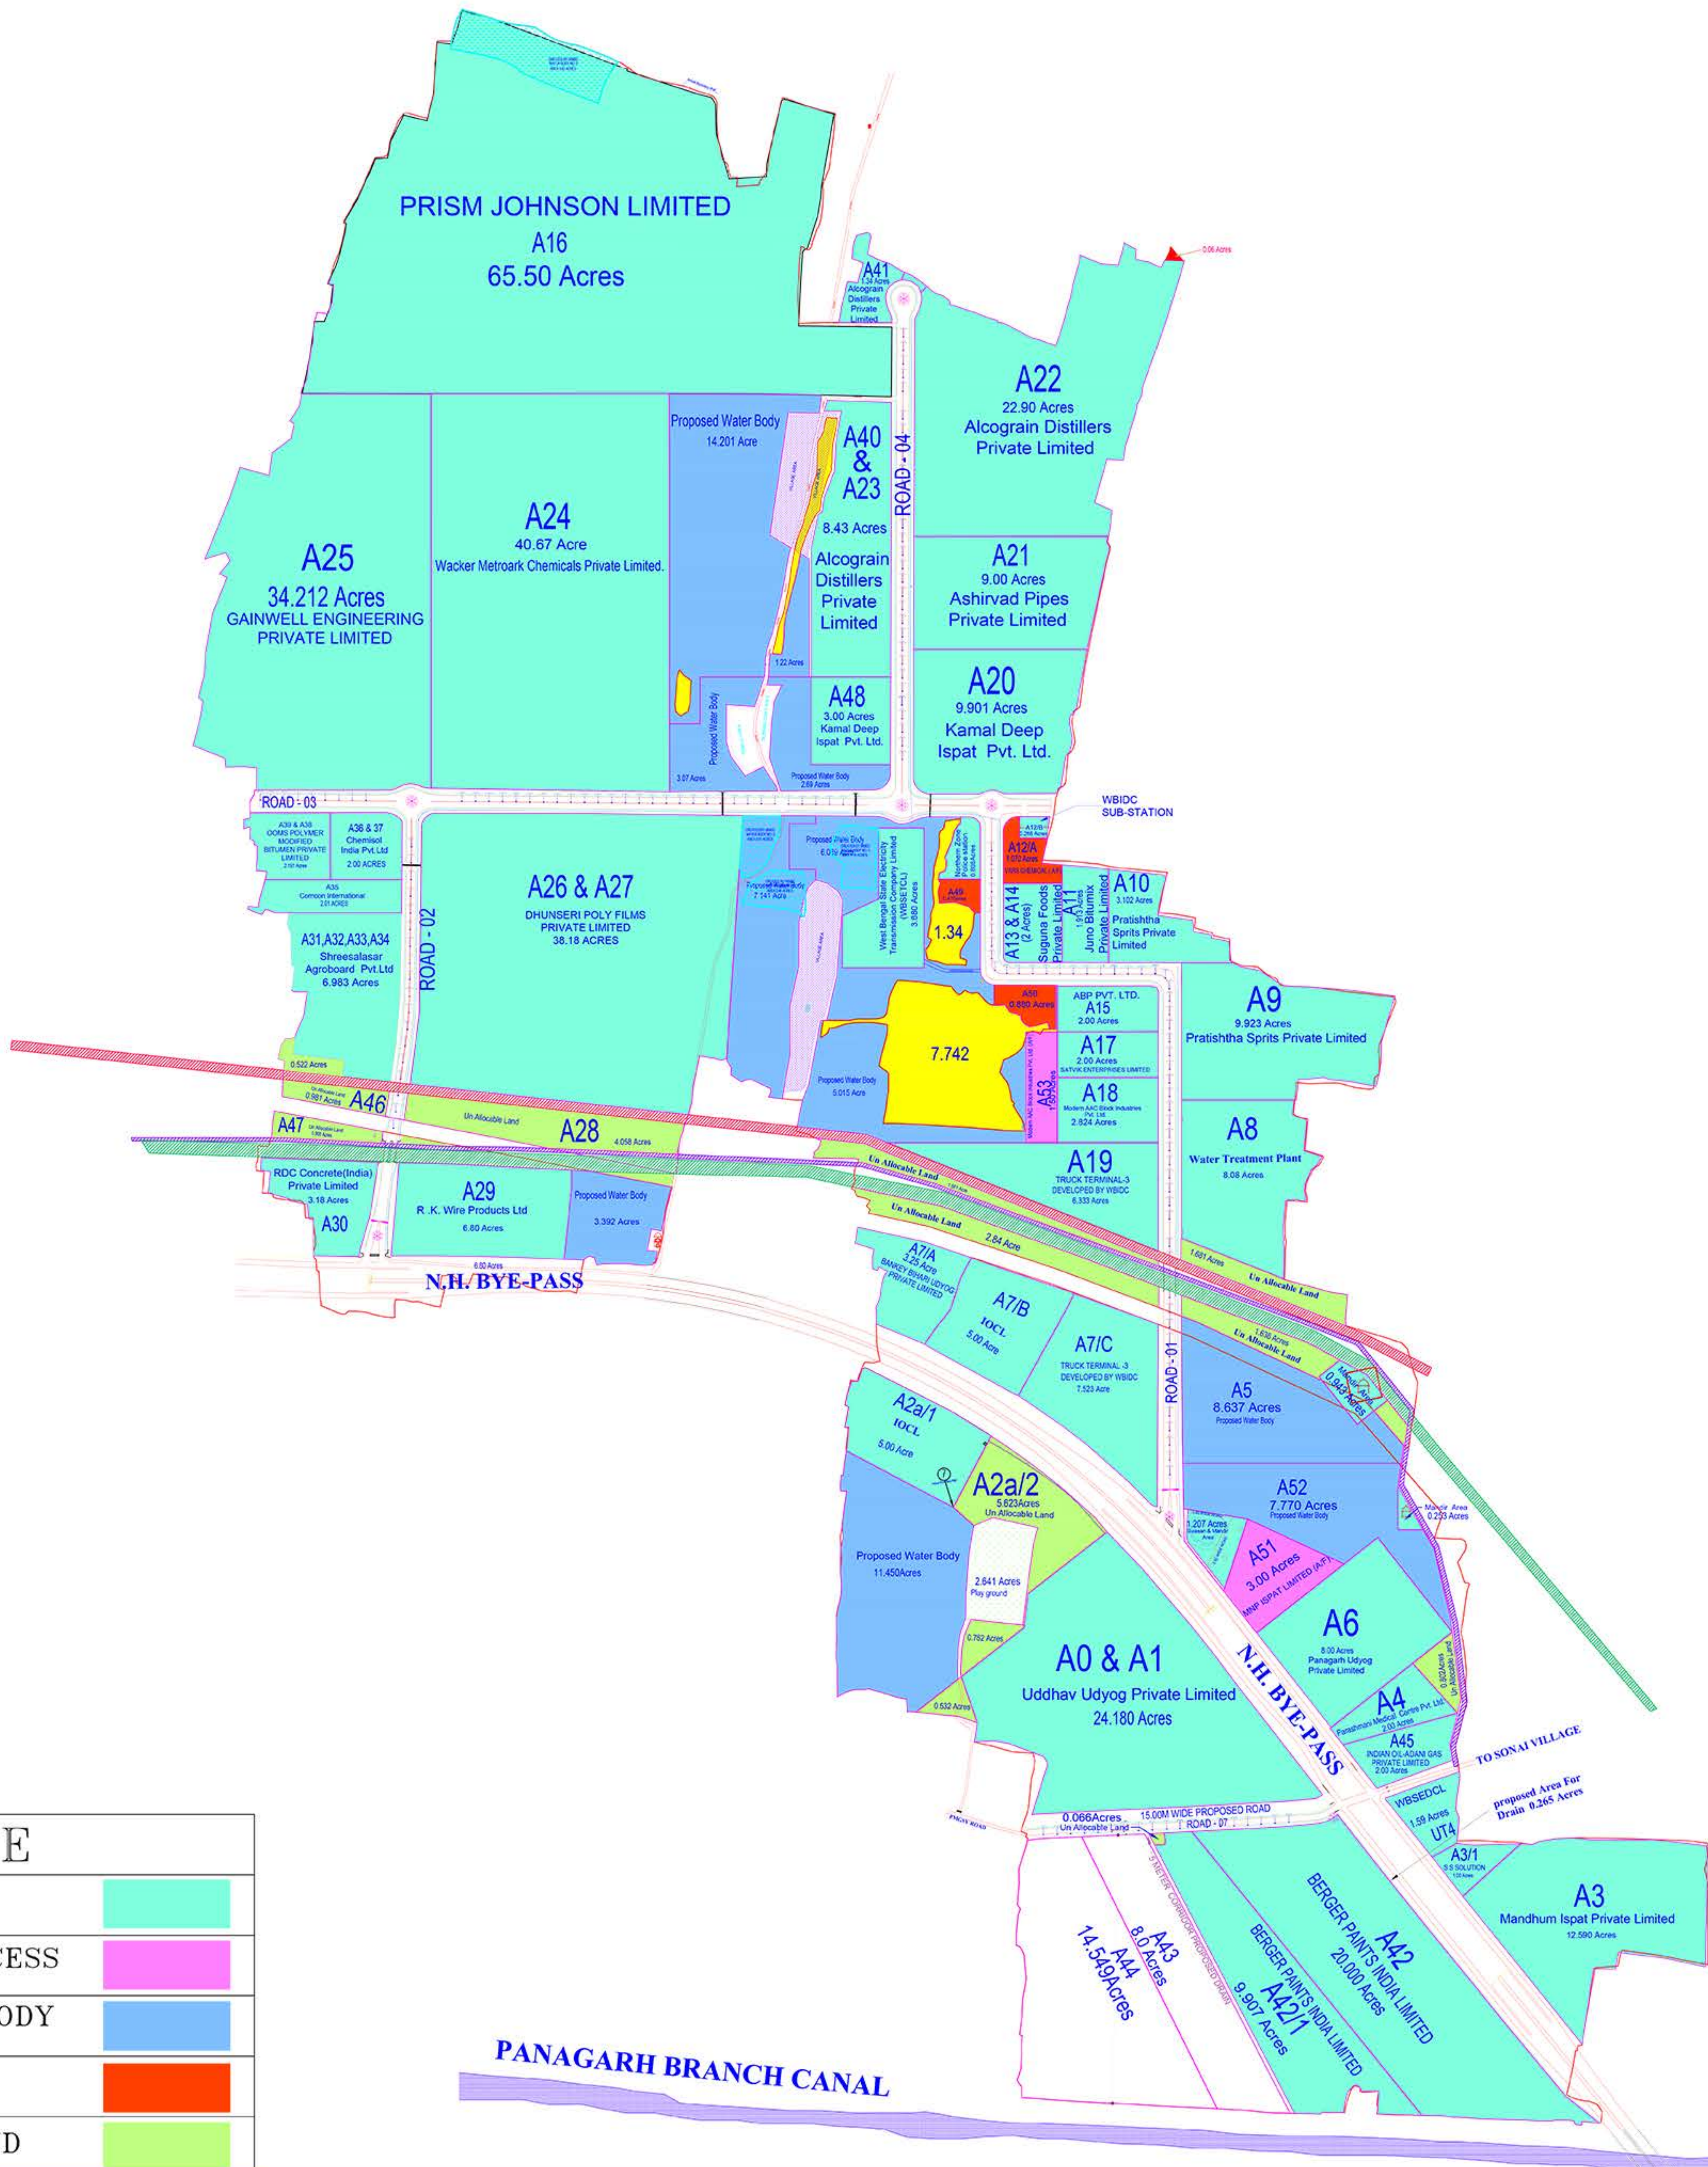

NOTE	
ALLOTTED LAND	
ALLOTMENT IN PROCESS	
PROPOSED WATER BODY	
VACANT PLOT	
UN ALLOCAABLE LAND	

LEGEND	
BOUNDARY WALL	
CABAL CHAMBER	
CALVART	
ELECTRIC POST	
ENCLOSMENT	
FEDGER BOX	
FLY OVERS	
GATE	
IRON MIST	
KIOSK SCHOOL	
PLAY GROUND	
ROAD	
SADAN AN VILLAGE AREA	
SOB BOX	
SUB BOX	
STREET LIGHT	
SWITCH VALVE	
TEMPLE	
TRANSFORMA	
Rail Track	
P.T.P.B.M	
H.T TOWER	
KOG PIPE LINE	
ESSAR PIPE LINE	
UTILITY POWER CORRIDOR	

LIST OF REFERENCE MASTER PILLAR			
SL. NO.	NORTHING	EASTING	POINT ID
1	2594564.2960	547755.873	PIP-1
2	2594498.884	547880.418	PIP-2
3	2592025.264	550225.563	PIP-3
4	2591986.798	550364.777	PIP-4
5	2595106.857	547812.132	PIP-5
6	2595107.541	547844.785	PIP-6
7	2591711.075	550996.303	PIP-7
8	2591708.111	551020.854	PIP-8

NOTES:-
1. All Dimensions Are In m. Unless Otherwise Noted.
2. All Coordinate Are In True Coordinate

JUN 27		West Bengal Industrial Development Corporation	
TITLE		As Built MASTER PLAN AND TOPOGRAPHICAL SURVEY DRAWING OF NORTHEN SIDE PANAGARH INDUSTRIAL PARK	
Drawing No.:-		Work Order No.:-	
CONSULTANT:		NAME DATE	
DRAWN-SURVEY		N.C.K. 28.01.2023	
DESIGNED		SHEET: 0	
CHECKED		SCALE:	
APPROVED		Rev. 0	
Survey Agency		Rev.	
SURVEYOR		S S Solution	
AS-4/11, Srinagar Pally, Bensachity, Durgapur-13		Website: www.sssolutiongroup.com	
		EMAIL ID: sssolution_88@rediffmail.com	